


Code:

# STW4R-V

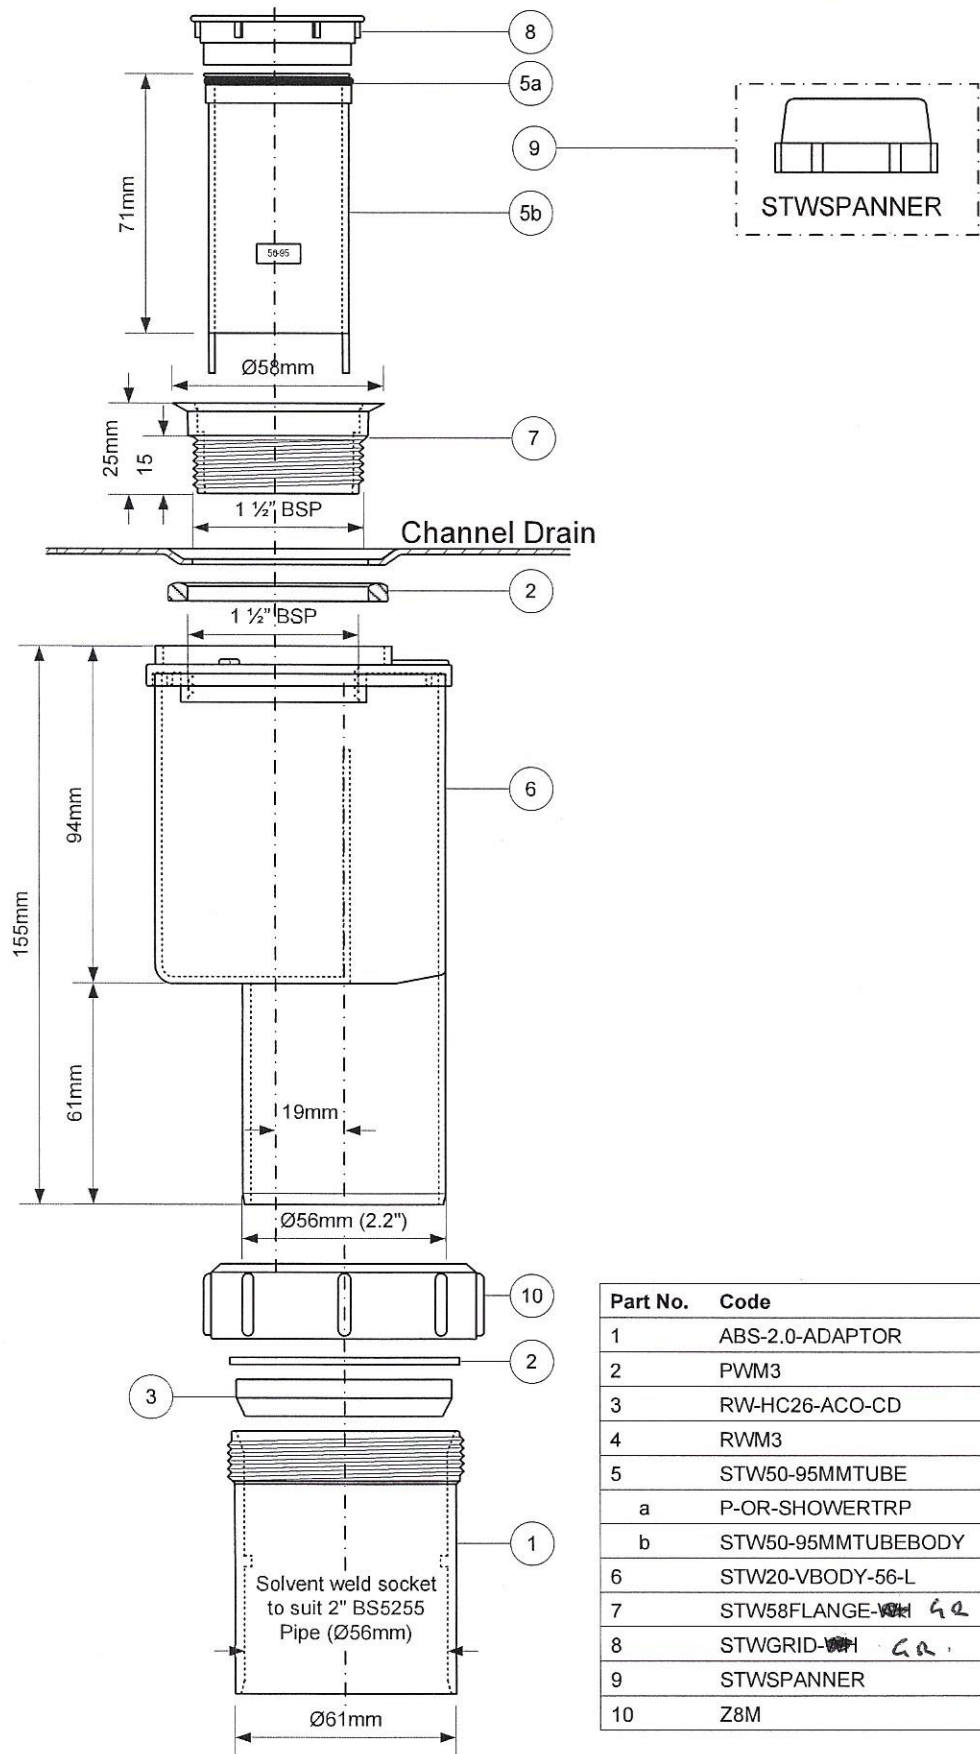

Part No.	Code
1	ABS-2.0-ADAPTOR
2	PWM3
3	RW-HC26-ACO-CD
4	RWM3
5	STW50-95MMTUBE
a	P-OR-SHOWERTRP
b	STW50-95MMTUBEBODY
6	STW20-VBODY-56-L
7	STW58FLANGE- <del>W1</del> <i>W1 G2</i>
8	STWGRID- <del>W1</del> <i>W1 G2</i>
9	STWSPANNER
10	Z8M

Drawing verified correct as of:

03/05/2016

DRAWN BY

RM

REVISED

FILENAME

STW4R-V.VSD

SCALE

DATE